

EXAMPLE ONLY



PROJECT DETAILS

Permit Number ...PD65/20.....

Address...25 Toms Close, Goondiwindi.....


Lot and Plan Details...Lot 32 on SP254157.....

AS CONSTRUCTED INSTALLED BY

Responsible Person...Anthony Smith Plumbing.....

Licence Number...765432.....

Date...01 June 2020.....

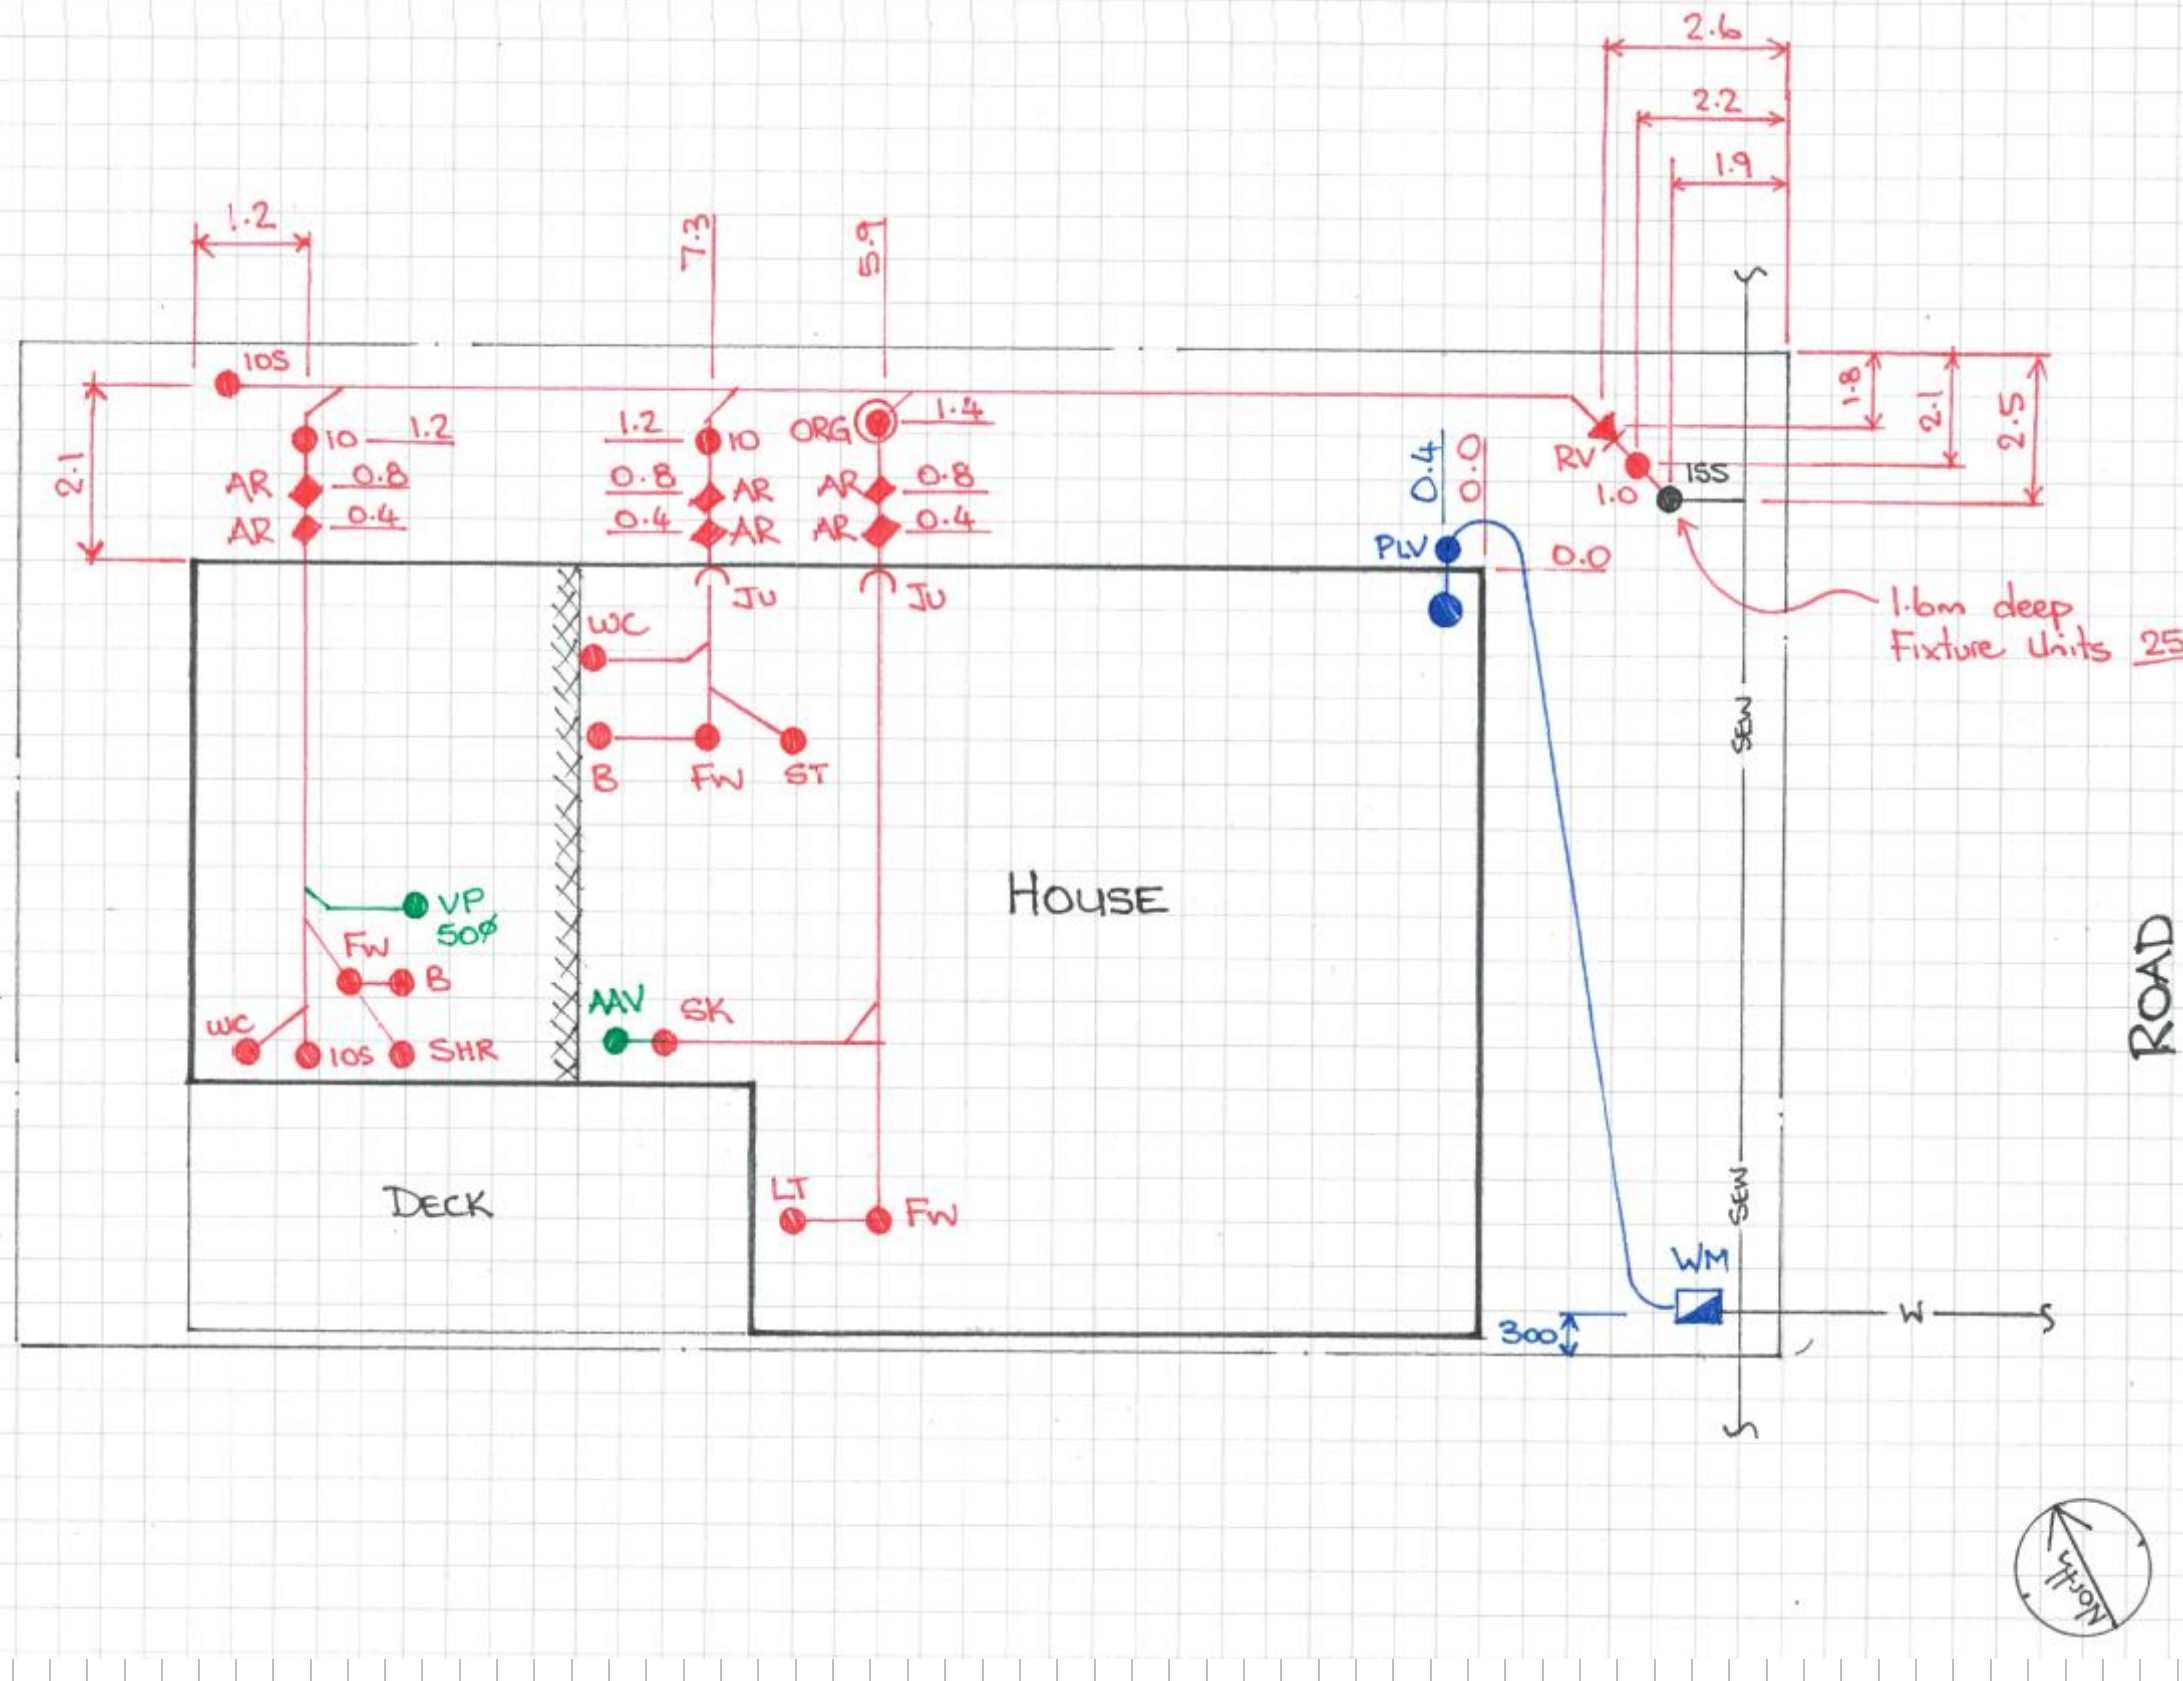

LEGEND

ABBREVIATIONS

- AAV AIR ADMITTANCE VALVE
- AR ARTICULATION
- B BASIN
- BID BIDET
- BTH BATH
- CWM CLOTHES WASHING MACHINE
- DG DISCONNECTOR GULLY
- FW FLOOR WASTE GULLY
- GIT GREASE INTERCEPTOR TRAP
- IO INSPECTION OPENING
- IOS INSPECTION OPENING TO SURFACE
- ISS INSPECTION SHAFT TO SURFACE
- JU JUMP UP
- LT LAUNDRY TROUGH
- ORG OVERFLOW RELIEF GULLY
- PCV PRESSURE CONTROL VALVE
- SAN SANITARY DRAIN / PLUMBING
- SHR SHOWER
- SK SINK
- SPA SPA BATH
- ST STACK
- TD TUNDISH
- VP VENT PIPE
- WC WATER CLOSET
- WM WATER METER
- WWTP WASTE WATER TREATMENT PLANT

NEW SERVICE

- BORE WATER --- BW ---
- IRRIGATION --- IR ---
- HOUSE DRAIN --- HD ---
- VENT --- V ---
- WATER --- W ---

GENERAL

- BOUNDARY ---
- RETAINING WALL XXXXXXXXXX

DRAWN Sign here	DATE 01/06/20	SHEET 1/1	REV. 1
--------------------	------------------	--------------	-----------